


CERTIFICATE OF SURVEY
FOR: STONEHEARTH CUSTOM HOMES


PROJECT LOCATION:

5113 59TH STREET WEST
 EDINA, MN 55410

w/permit #85371

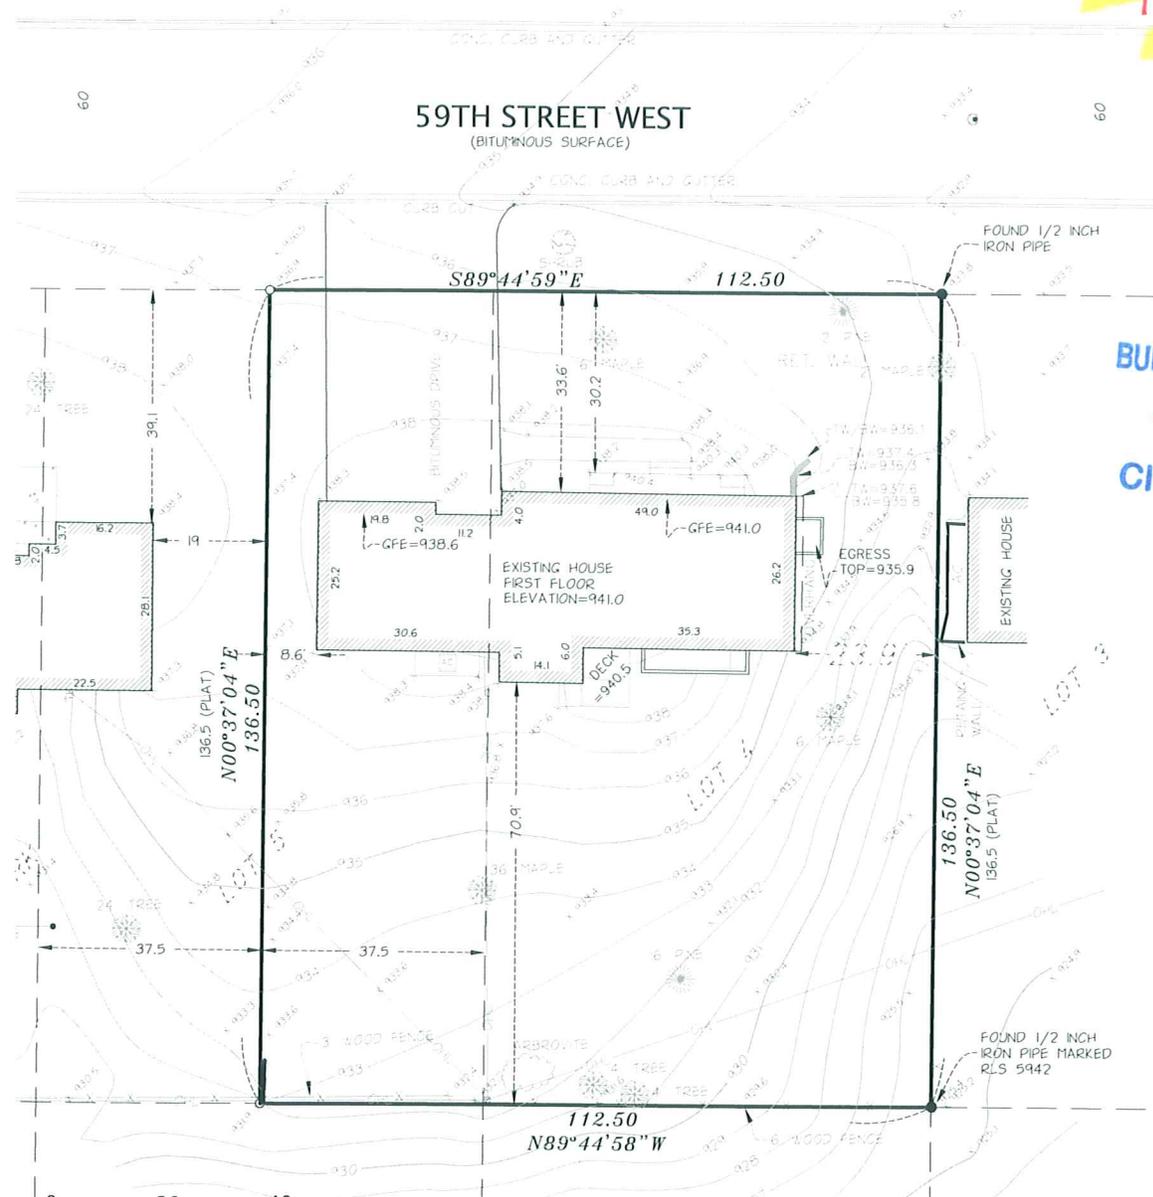

BUILDING DEPARTMENT
AUG 16 2008
CITY OF EDINA

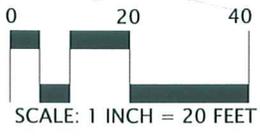

LEGEND:

| SYMBOLS | DESCRIPTION | | DESCRIPTION |
|---------|-------------------------------------|-------|---|
| —○— | PROPERTY LINE | ● | DENOTES FOUND 1/2" IRON PIPE |
| —○— | EASEMENT LINE | ○ | DENOTES SET 1/2" IRON PIPE MARKED RLS 25718 |
| □ | DENOTES 10' OFFSET HUB | —909— | PROPOSED CONTOURS |
| x 985.0 | DENOTES EXISTING ELEV. | ○ | EXISTING ELEVATIONS |
| ○ 985.0 | DENOTES PROPOSED ELEV. | | |
| → | DIRECTION OF PROP. SURFACE DRAINAGE | | |

As-built Final Grade

- ◆ **EXISTING LEGAL DESCRIPTION**
 Lot 4 and the east half of Lot 5, Block 2, BENTON PARK, Hennepin County, Minnesota.
- ◆ **AREA SUMMARY:**
 TOTAL OF PARCEL = 15,342 sq.ft.
- ◆ **CERTIFICATION:**

◆ **NOTES:**
 UNDERGROUND UTILITIES NOT LOCATED OR SHOWN EASEMENTS, IF ANY, MAY EXIST. THERE WAS NO EFFORT MADE TO RESEARCH RECORDED OR UNRECORDED EASEMENTS. BEARINGS ARE ASSUMED. ELEVATION ARE BASED ON BENCH MARKS PROVIDED BY THE CITY OF EDINA WHICH IS A TOP NUT HYDRANT LOCATED AT THE CORNER OF TINGDALE AVE AND WEST 59TH STREET. TNH=930.95

I hereby certify that this survey, plan or report was prepared by me or under my direct supervision and that I am a duly licensed Land Surveyor under the laws of the State of MINNESOTA.

Daniel L. Hurmes
 DANIEL L. HURMES
 License. No. 25718 Date 7-14-08

Suite #B100
 200 East Chestnut Street
 Stillwater, MN 55082
 Phone 651.275.8969
 Fax 651.275.8976
 dlh-csls@mcleodusa.net

CORNERSTONE
 LAND SURVEYING, INC

5113 59th ST W