B. H. BRADLEY
CIVIL ENGINEER AND SURVEYOR
3829 - 24TH AVENUE SOUTH
MINNEAPOLIS 6, MINN.
PARKWAY 4-2169

Survey for- Herman Trones
6944 Oliver Ave. S.
Scale 1" = 30'

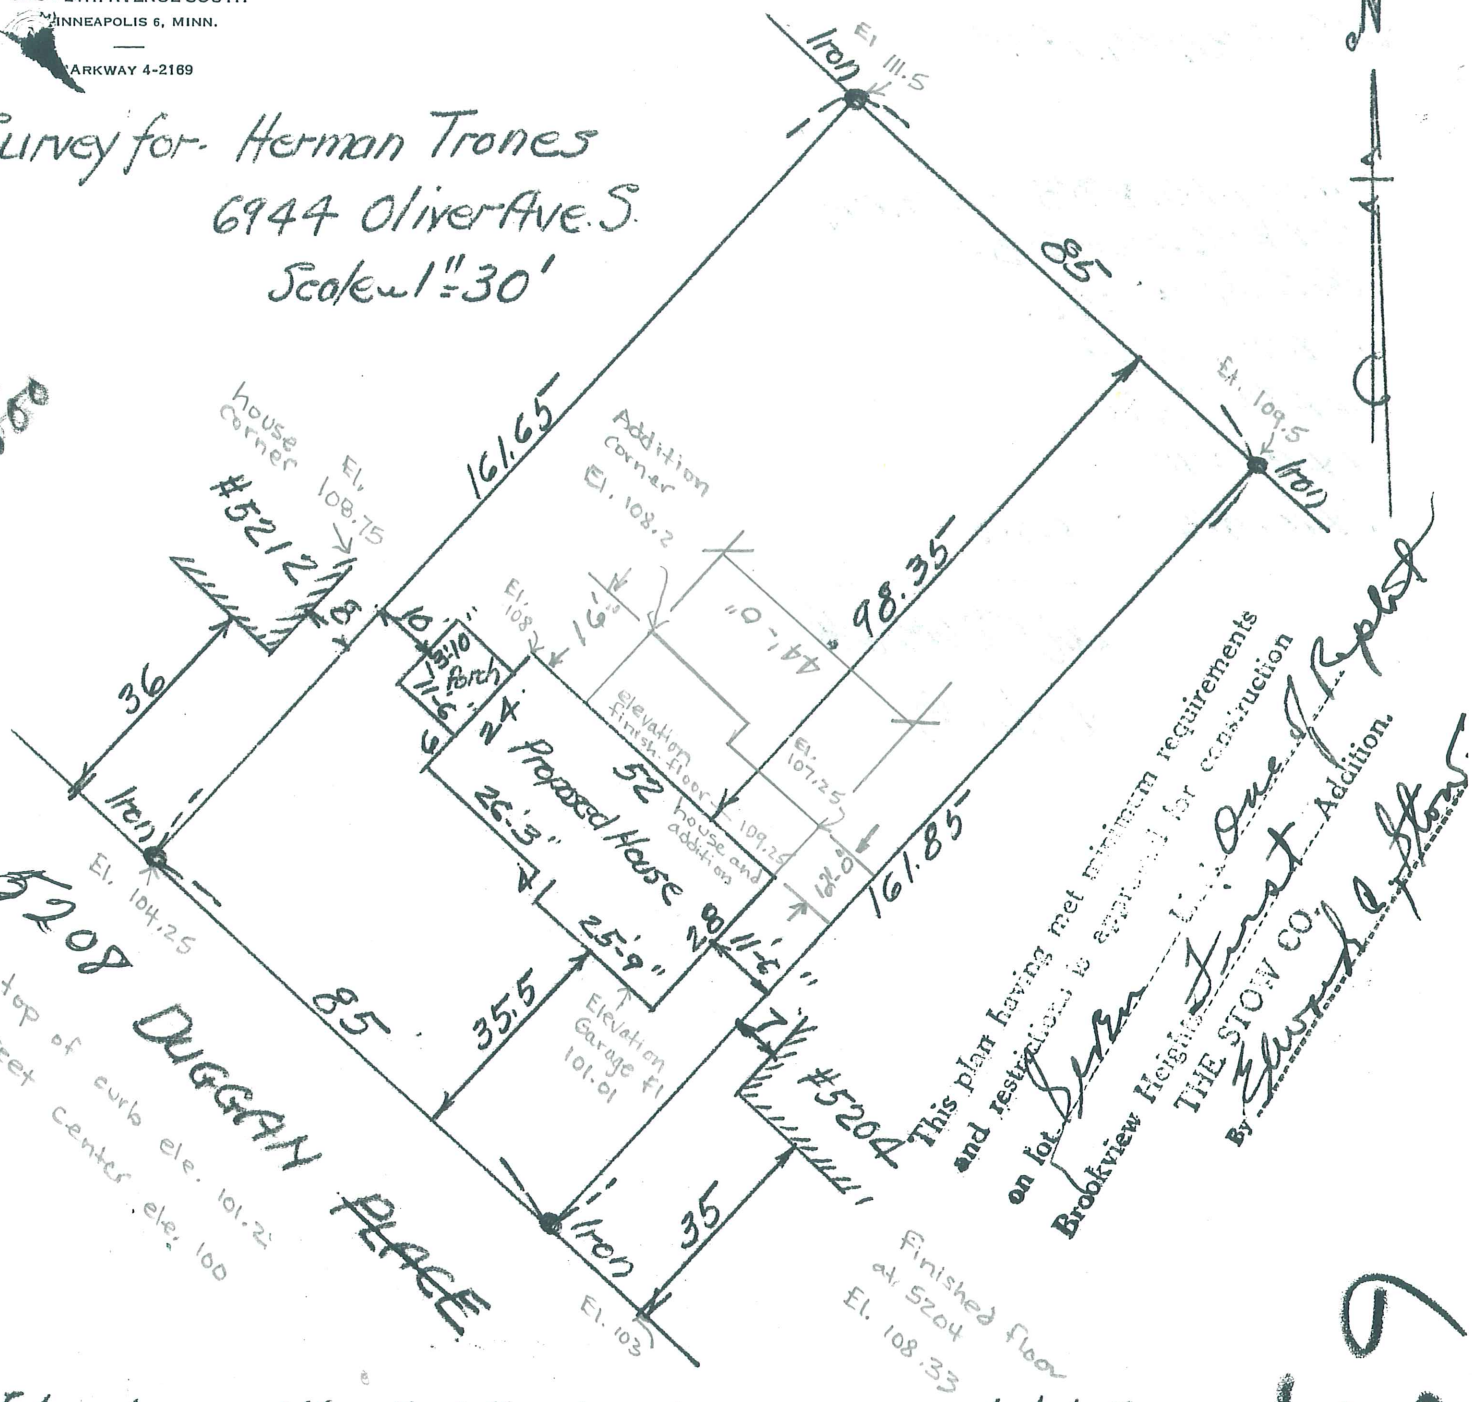

92.560

I hereby certify that this is a true and correct plat of a survey of Lot 7, Block 1, Replat of South Half of Block 7, Brookview Heights First Addition as surveyed by me the 24th day of August 1955.

B H Bradley
Surveyor.

08.12.98
5208 DUGGAN PLAZA

13,748.75 ~~$~~

25% = 3437.18 ~~$~~

11.5 x 13.833 = 159.079
24 x 26.25 = 630
25.75 x 28 = 721
12 x 22 = 264
16 x 22 = 352
1 x 10 = 10
1 x 10.916 = 10.916

~~[illegible]~~

2146.09