CERTIFICATE OF SURVEY

for

New Spaces Home Craftsman

Scale: 1" = 30'

○ Denotes 1/2 inch by 14 inch iron pipe monument set, marked with a plastic cap inscribed "RIVARD RLS 19421"

● Denotes 1/2 inch iron pipe monument found.

The orientation of this Bearing System is assumed.

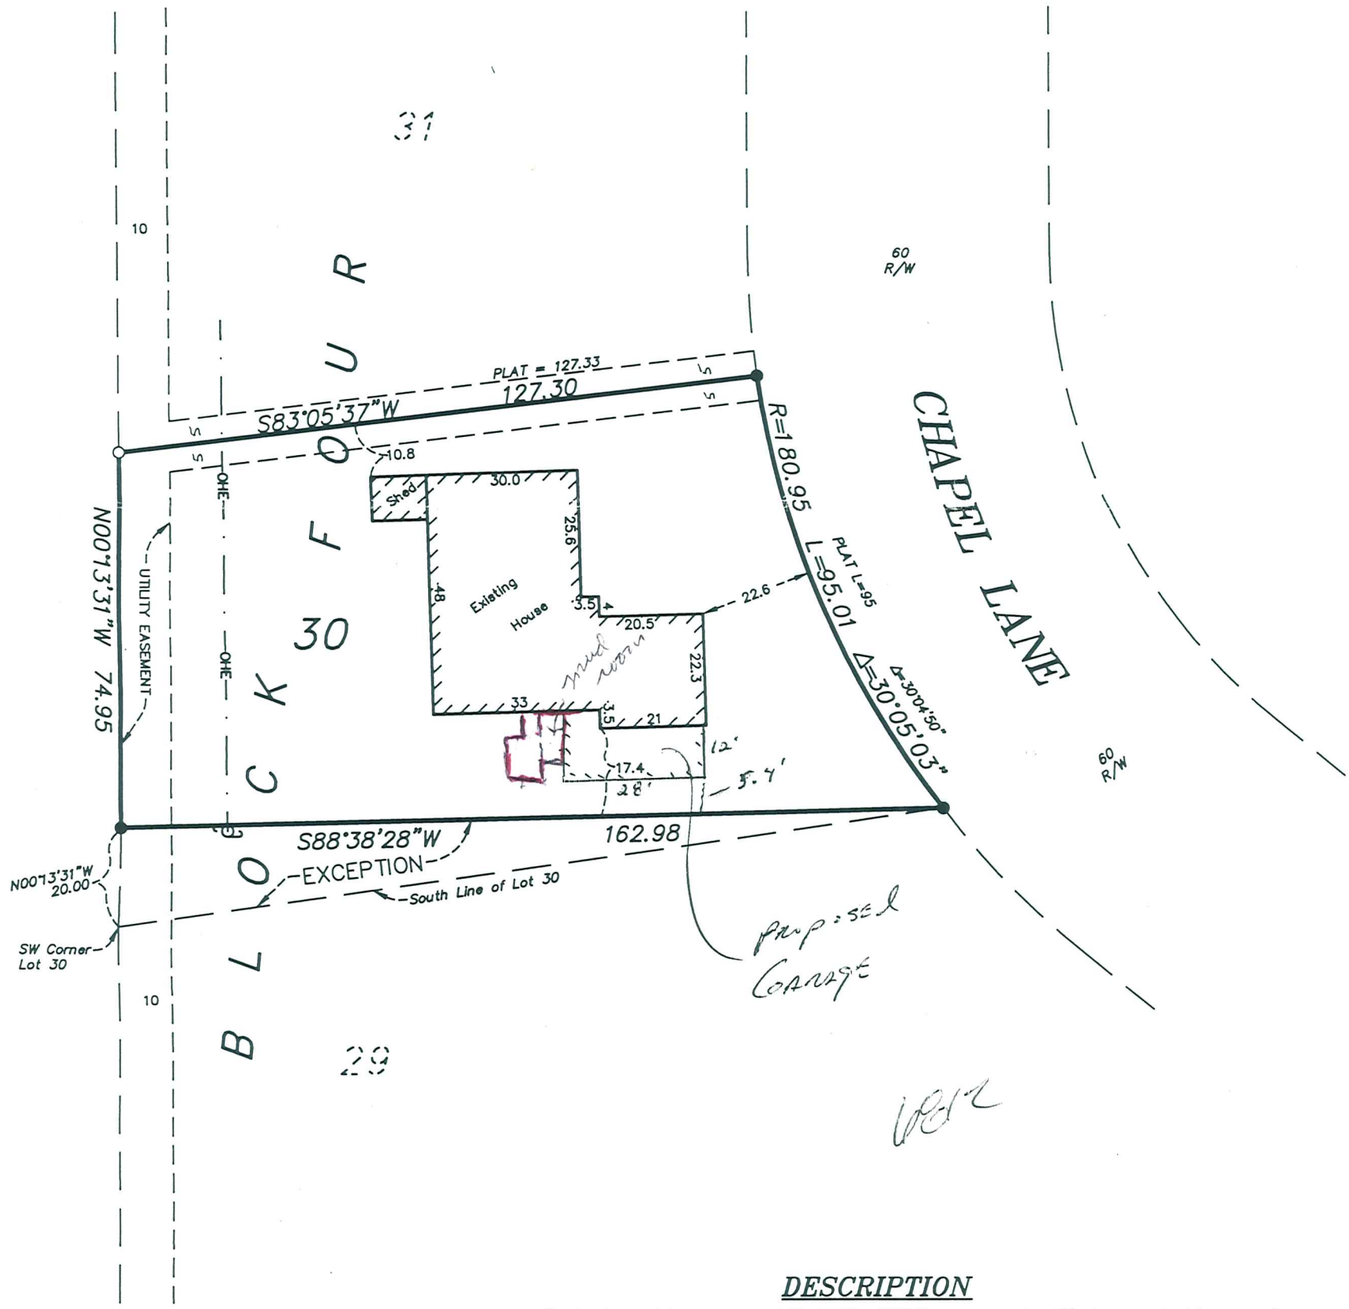

DESCRIPTION

Lot 30, Block 4, CHAPEL HILL, except that part thereof lying southerly of a line running from the southeast corner of said lot to a point in the west line of said lot, distant 20 feet north of the southwest corner thereof, Hennepin County, Minnesota.

6808 CHAPEL LA

MIDWEST
Land Surveyors & Civil Engineers, Inc.
710 East River Road
Anoka, Mn. 55303
Ph. 763-712-9099 Fax: 763-712-9055

Job No. 00-154 Book-Page dcf Acad File 00-154

©2000 - Midwest Land Surveyors & Civil Engineers, Inc. - All Rights Reserved.

I hereby certify that this survey, plan or report was prepared by me or under my direct supervision and that I am a duly Licensed Land Surveyor under the laws of the State of Minnesota.
and
No certification whatsoever is extended to subsequent owners, mortgagees or title insurers, unless this survey has been redated for this purpose by the surveyor.

Dated this 27th day of March, 2000

By _____ Registration No. 19421

Blake L. Rivard - Minnesota Licensed Land Surveyor

Asbuilt _____ Dated this _____ day of _____, 20____

NOTE: Official Copies of This Survey are Crimp Sealed.